

KERRY MAGALOUZ CONSTRUCTION COMPANY
 2000 SW 10th Ave, Suite 200
 Portland, OR 97204
 Phone: (503) 251-1111
 Fax: (503) 251-1112
 Website: www.kerryarch.com

RFI # 4
 Date: 03/27/2011
 To: STEELE ASSOCIATES ARCHITECTS
 760 NW York Dr., Suite 200
 Madras, OR 97554
 Phone: (541) 382-9867 Fax: (541) 382-9816

RFI # 12
 Date: 03/27/2011
 To: STEELE ASSOCIATES ARCHITECTS
 760 NW York Dr., Suite 200
 Madras, OR 97554
 Phone: (541) 382-9867 Fax: (541) 382-9816

RFI # 13
 Date: 03/27/2011
 To: STEELE ASSOCIATES ARCHITECTS
 760 NW York Dr., Suite 200
 Madras, OR 97554
 Phone: (541) 382-9867 Fax: (541) 382-9816

RFI # 14
 Date: 03/27/2011
 To: STEELE ASSOCIATES ARCHITECTS
 760 NW York Dr., Suite 200
 Madras, OR 97554
 Phone: (541) 382-9867 Fax: (541) 382-9816

Subject: Fire Service Thrust Blocks
Drawing: C200
Scale: As Shown
Date: 03/27/2011



Request: Please provide the Fire Service Thrust Block details for the Thrust Blocks at F83, F54 and F55. It is acceptable to use Mega-Loc connections if these are not available in the area of the Thrust Blocks.

Response: Please proceed with the proposed location. Michael Slovacek Interface Engineering, Inc. 06-13-11

Requested by: Alan Hansen
 KERRY MAGALOUZ

Approved by: Alan Hansen
 KERRY MAGALOUZ

Company: WHPacific, Inc.
 Date: 03/27/2011

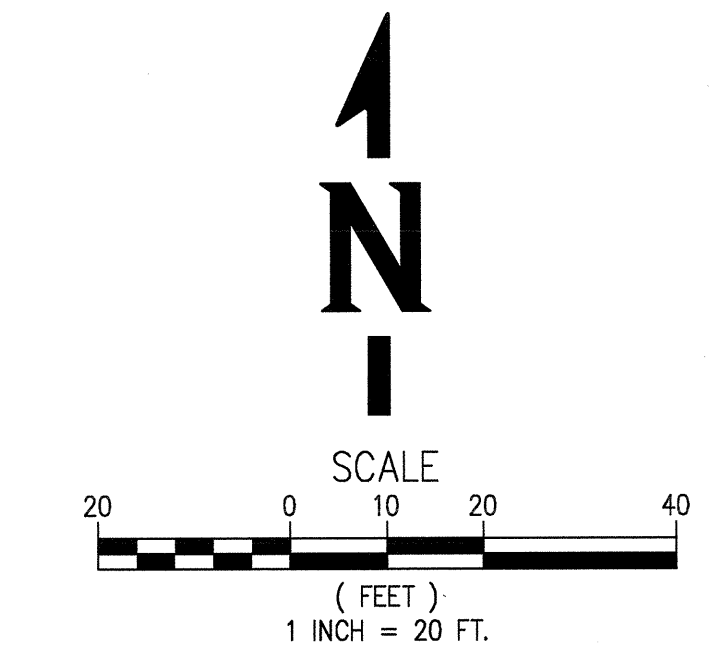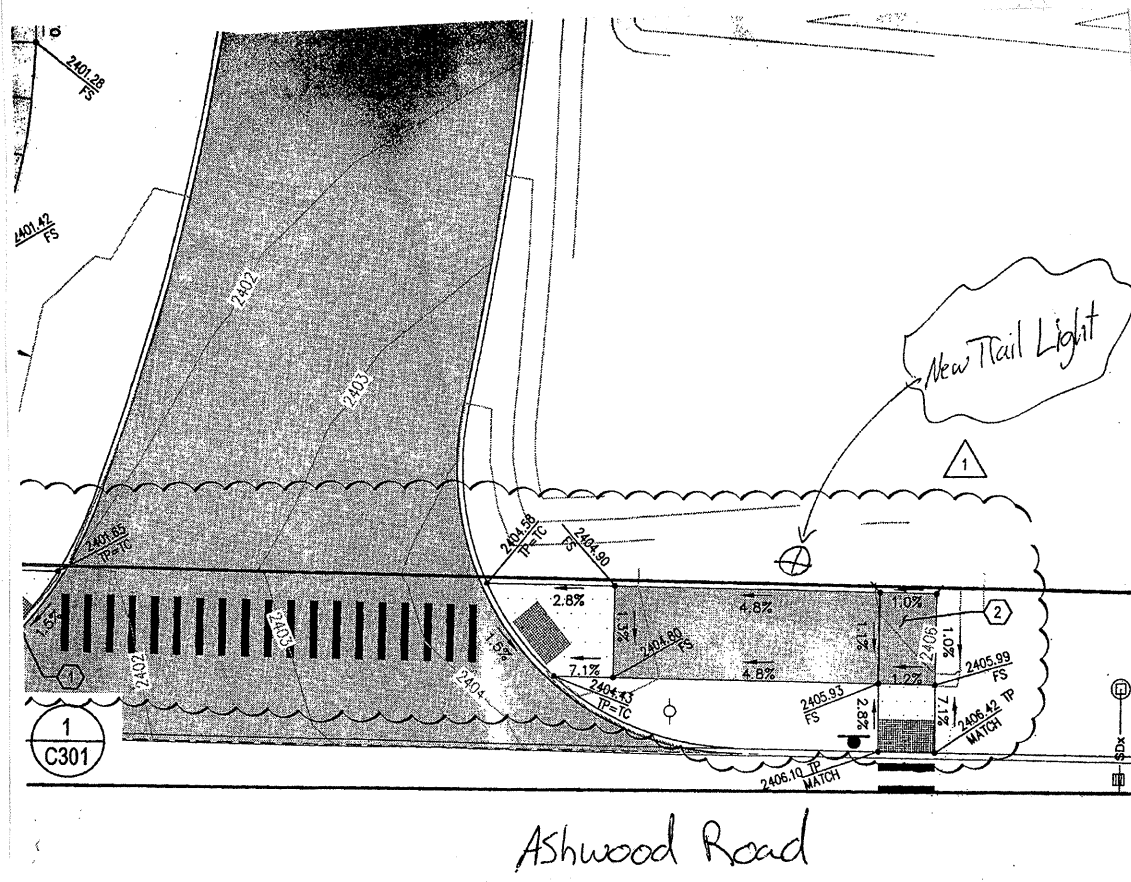

WATER CONSTRUCTION NOTES:

- (W1) INSTALL 8"x2" TEE, INSTALL STAINLESS STEEL TAPPING SLEEVE AND 2" GATE VALVE. (TAPPING) BEGIN INSTALLATION OF 2" SCH 40 WATER LINE, AT A MINIMUM OF 36" COVER. (SLEEVE AND GATE VALVE TO BE INSTALLED BY DESCHUTES VALLEY WATER DISTRICT.)
- (W2) INSTALL 2" WATER METER PER DETAIL 2/C503.
- (W3) INSTALL 2" DOUBLE CHECK VALVE ASSEMBLY PER DETAIL 1/C503.
- (W4) INSTALL 2"-11.25" BEND.
- (W5) INSTALL 2"-90° BEND.
- (W6) INSTALL 2" CAP WITHIN 5' OF THE BUILDING WALL FOR FUTURE CONNECTION BY THE BUILDING PLUMBER. END 2" SCH. 40 WATER LINE.
- (W7) NOT USED

- (W8) INSTALL FIRE HYDRANT PER 2008 OREGON STANDARD DRAWING NO. RD254, SEE SHEET C502. MODIFY THIS DETAIL TO INSTALL A 6" C900 PVC WATER LINE. NOT A DUCTILE IRON WATER LINE TO THE HYDRANT. MINIMUM COVER IS 36".
- (W9) INSTALL 2"-45" BEND.
- (W10) INSTALL 8"x2" TEE, INSTALL STAINLESS STEEL TAPPING SLEEVE AND 2" GATE VALVE. (TAPPING) BEGIN INSTALLATION OF 2" SCH 40 WATER LINE, AT A MINIMUM OF 36" COVER. (SLEEVE AND GATE VALVE TO BE INSTALLED BY DESCHUTES VALLEY WATER DISTRICT.)
- (W11) INSTALL 2" WATER METER PER DETAIL 2/C503 (FOR IRRIGATION).
- (W12) INSTALL 2" DOUBLE CHECK VALVE ASSEMBLY PER DETAIL 1/C503 (FOR IRRIGATION).
- (W13) SEE IRRIGATION PLAN FOR CONTINUATION OF IRRIGATION SERVICE
- (W14) CUT EXISTING WATER MAIN AND INSTALL 8"x6" TEE, THRUST BLOCK, AND 8" GATE VALVE. INSTALL THRUST BLOCK PER 2008 OREGON STANDARD DRAWINGS NO. RD250 AND RD258, SEE SHEET C502. BEGIN INSTALLATION OF 8" C900 PVC WATERLINE WITH A MIN. COVER OF 36". (CONNECTION AND INSTALLATION OF TEE, THRUST BLOCK, AND VALVE TO BE COMPLETED BY DESCHUTES VALLEY WATER DISTRICT. ALL 8" WATER MAIN TO THE REDUCER ALSO TO BE INSTALLED BY DESCHUTES VALLEY WATER DISTRICT.)

FIRE SERVICE CONSTRUCTION NOTES:

- (F1) INSTALL 8"x6" TEE, 6" GATE VALVE, AND 8"x6" REDUCER. BEGIN INSTALLATION OF 6" C900 PVC WATERLINE WITH A MIN. COVER OF 36". (TEE TO BE INSTALLED BY DESCHUTES VALLEY WATER DISTRICT.)
- (F2) INSTALL FIRE SPRINKLER SERVICE VAULT WITH PIV AND FDC PER DETAIL 3/C503. INSTALL OLDCASTLE PRECAST UTILITY VAULT NO. 687-WA OR APPROVED EQUAL.
- (F3) INSTALL 6"-11.25" BEND AND THRUST BLOCK.
- (F4) INSTALL 6"-90° BEND AND THRUST BLOCK.
- (F5) INSTALL 6"-45" BEND AND THRUST BLOCK.
- (F6) INSTALL 6" CAP WITHIN 5' OF THE BUILDING WALL FOR FUTURE CONNECTION BY THE BUILDING PLUMBER. END 6" C900 PVC WATER LINE.

IRRIGATION MAIN CONSTRUCTION NOTES:

- (I1) CONNECT TO EXISTING IRRIGATION GRAVITY MAIN. INSTALL 6"-22.5" BEND. INSTALL 74 L.F. OF CL-200 PVC MAIN AT S= 0.0021 FT/FT. POT HOLE TO VERIFY LOCATION AND DEPTH OF EXISTING MAIN, NOTIFY THE ENGINEER OF ANY DISCREPANCIES.
- (I2) INSTALL 6"-22.5" BEND.
- (I3) INSTALL 12 L.F. OF CL-200 PVC MAIN AT S= 0.0021 FT/FT.
- (I4) INSTALL 6"-22.5" BEND.
- (I5) INSTALL 14 L.F. OF CL-200 PVC MAIN AT S= 0.0021 FT/FT.
- (I6) INSTALL 6"-22.5" BEND.
- (I7) INSTALL 210 L.F. OF CL-200 PVC MAIN AT S= 0.0021 FT/FT.
- (I8) INSTALL 6"-45" BEND.
- (I9) INSTALL 54 L.F. OF CL-200 PVC MAIN AT S= 0.0021 FT/FT.
- (I10) INSTALL 6"-45" BEND.
- (I11) INSTALL 116 L.F. OF CL-200 PVC MAIN AT S= 0.0021 FT/FT.
- (I12) CONNECT TO EXISTING IRRIGATION GRAVITY MAIN.
- (I13) EXISTING 6" IRRIGATION MAIN IS TO BE REMOVED. BACKFILL AND COMPACT TRENCH PER GEOTECHNICAL ENGINEER RECOMMENDATIONS.

SANITARY SEWER SERVICE CONSTRUCTION NOTES:

- (S1) INSTALL STANDARD SANITARY SEWER MANHOLE WITH 1 FOOT INSIDE DROP PER 2008 OREGON STANDARD DRAWING NO. RD338, SEE 1/C505. RM EL= 2400.53, 4" I.E. (IN, FROM BUILDING)= 2393.50, 4" I.E.(OUT)= 2392.50' INSTALL 32 L.F. OF 4" 3034 PVC SEWER PIPE AT S=0.029 FT/FT.
- (S2) INSTALL SANITARY SEWER CLEAN OUT PER 2008 OREGON STANDARD DRAWING NO. RD362, SEE SHEET C504. 4" I.E.= 2391.56'
- (S3) INSTALL 82 L.F. OF 4" 3034 PVC SEWER PIPE AT S=0.029 FT/FT.
- (S4) INSTALL STANDARD SANITARY SEWER SHALLOW MANHOLE PER 2008 OREGON STANDARD DRAWING NO. RD342, SEE SHEET C202. RM EL=2392.53, IE (4" IN)=2389.16, IE (4" OUT)=2389.06.
- (S5) INSTALL 64 L.F. OF 4" C900 PVC SEWER PIPE AT S=0.009 FT/FT. CENTER ONE PIPE LENGTH OF 4" C900 SEWER PIPE OVER EXISTING WATER MAIN SEE PROFILE 2/C202. CONNECT SERVICE TO EXISTING SEWER MANHOLE.


NOTE: SEE SHEET C202 FOR SANITARY SEWER SERVICE PROFILE.

GENERAL CONSTRUCTION NOTES:

- (G1) PROPOSED TRASH ENCLOSURE. SEE ARCHITECTURAL PLANS FOR INFORMATION.
- (G2) PROPOSED CURB OPENING WITH APRON. SEE DETAIL 8/C503 FOR ADDITIONAL INFORMATION.
- (G3) PROPOSED ADA SIGNS (TYP.). SEE DETAIL 4/C503 FOR ADDITIONAL INFORMATION.
- (G4) PROPOSED PARKING BUMPER (TYP.). SEE DETAIL 6/503 FOR ADDITIONAL INFORMATION.
- (G5) CONSTRUCT 8" OF 3/4"-0 AGGREGATE BASE PARKING LOT AND ACCESS DRIVE.
- (G6) CONSTRUCT ADA RAMP PER OREGON STANDARD DRAWING NO. RD745, SEE SHEET C500.
- (G7) CONSTRUCT ACCESSIBLE STALL WITH SIGNAGE, REFER TO DETAIL 4/C503.
- (G8) CONSTRUCT 2" ASPHALT CONCRETE OVER 6" 3/4"-0 AGGREGATE BASE MATERIAL.
- (G9) CONSTRUCT STANDARD 12" CONCRETE CURB WITH 6" REVEAL PER OREGON STANDARD DRAWING NO. RD700, SEE SHEET C500.
- (G10) CONSTRUCT FLUSH CURB AT ACCESSIBLE STALLS. SEE GRADING PLAN FOR TRANSITION AND ELEVATION INFORMATION, (SHEET C300).
- (G11) PROPOSED PARKING LOT LIGHT, SEE ARCHITECTURAL PLANS. SEE DETAIL 7/C503 FOR LIGHT POLE BASE.
- (G12) PROPOSED 8" WIDE AC PATH, SEE SHEET C400 FOR MORE INFORMATION.
- (G13) PROPOSED ASHWOOD ROAD STRIPING, SEE SHEET C400.
- (G14) INSTALL 4" CONCRETE ON 4" AGGREGATE BASE PER OREGON STANDARD DRAWING RD720.
- (G15) SAWCUT AND REMOVE EXISTING CURB AT NEW DRIVEWAY ENTRANCE.
- (G16) SAWCUT EXISTING PAVEMENT TO COMPLETE SEWER SERVICE CONNECTION. PLACE TACK ON EXISTING PAVEMENT EDGES PRIOR TO THE NEW ASPHALT INSTALLATION. SEAL NEW EDGE WITH HOT TACK AND SAND SLURRY MIXTURE. PLACE CTB BACKFILL IN TOP 12" OF TRENCH AND COMPACT TO ODOT STANDARDS.

FRANCHISE UTILITY CONSTRUCTION NOTES:

- (F1) EXISTING GAS MAIN IS TO REMAIN, COORDINATE WITH CASCADE NATURAL GAS.
- (F2) INSTALL POWER UTILITY VAULT, SEE ELECTRICAL SITE PLAN FOR DESIGN INFORMATION. COORDINATE INSTALLATION WITH CENTRAL ELECTRIC COOPERATIVE.
- (F3) INSTALL CONDUIT FOR TELEPHONE SERVICE. SEE ELECTRICAL SITE PLAN FOR SIZE AND NUMBER OF CONDUIT REQUIRED.
- (F4) INSTALL CONDUIT FOR CABLE TV SERVICE. SEE ELECTRICAL SITE PLAN FOR SIZE AND NUMBER OF CONDUIT REQUIRED.
- (F5) INSTALL CONDUIT FOR POWER SERVICE. SEE ELECTRICAL SITE PLAN FOR SIZE AND NUMBER OF CONDUIT REQUIRED.
- (F6) PROPOSED POWER METER. SEE ELECTRICAL PLANS FOR MORE INFORMATION.

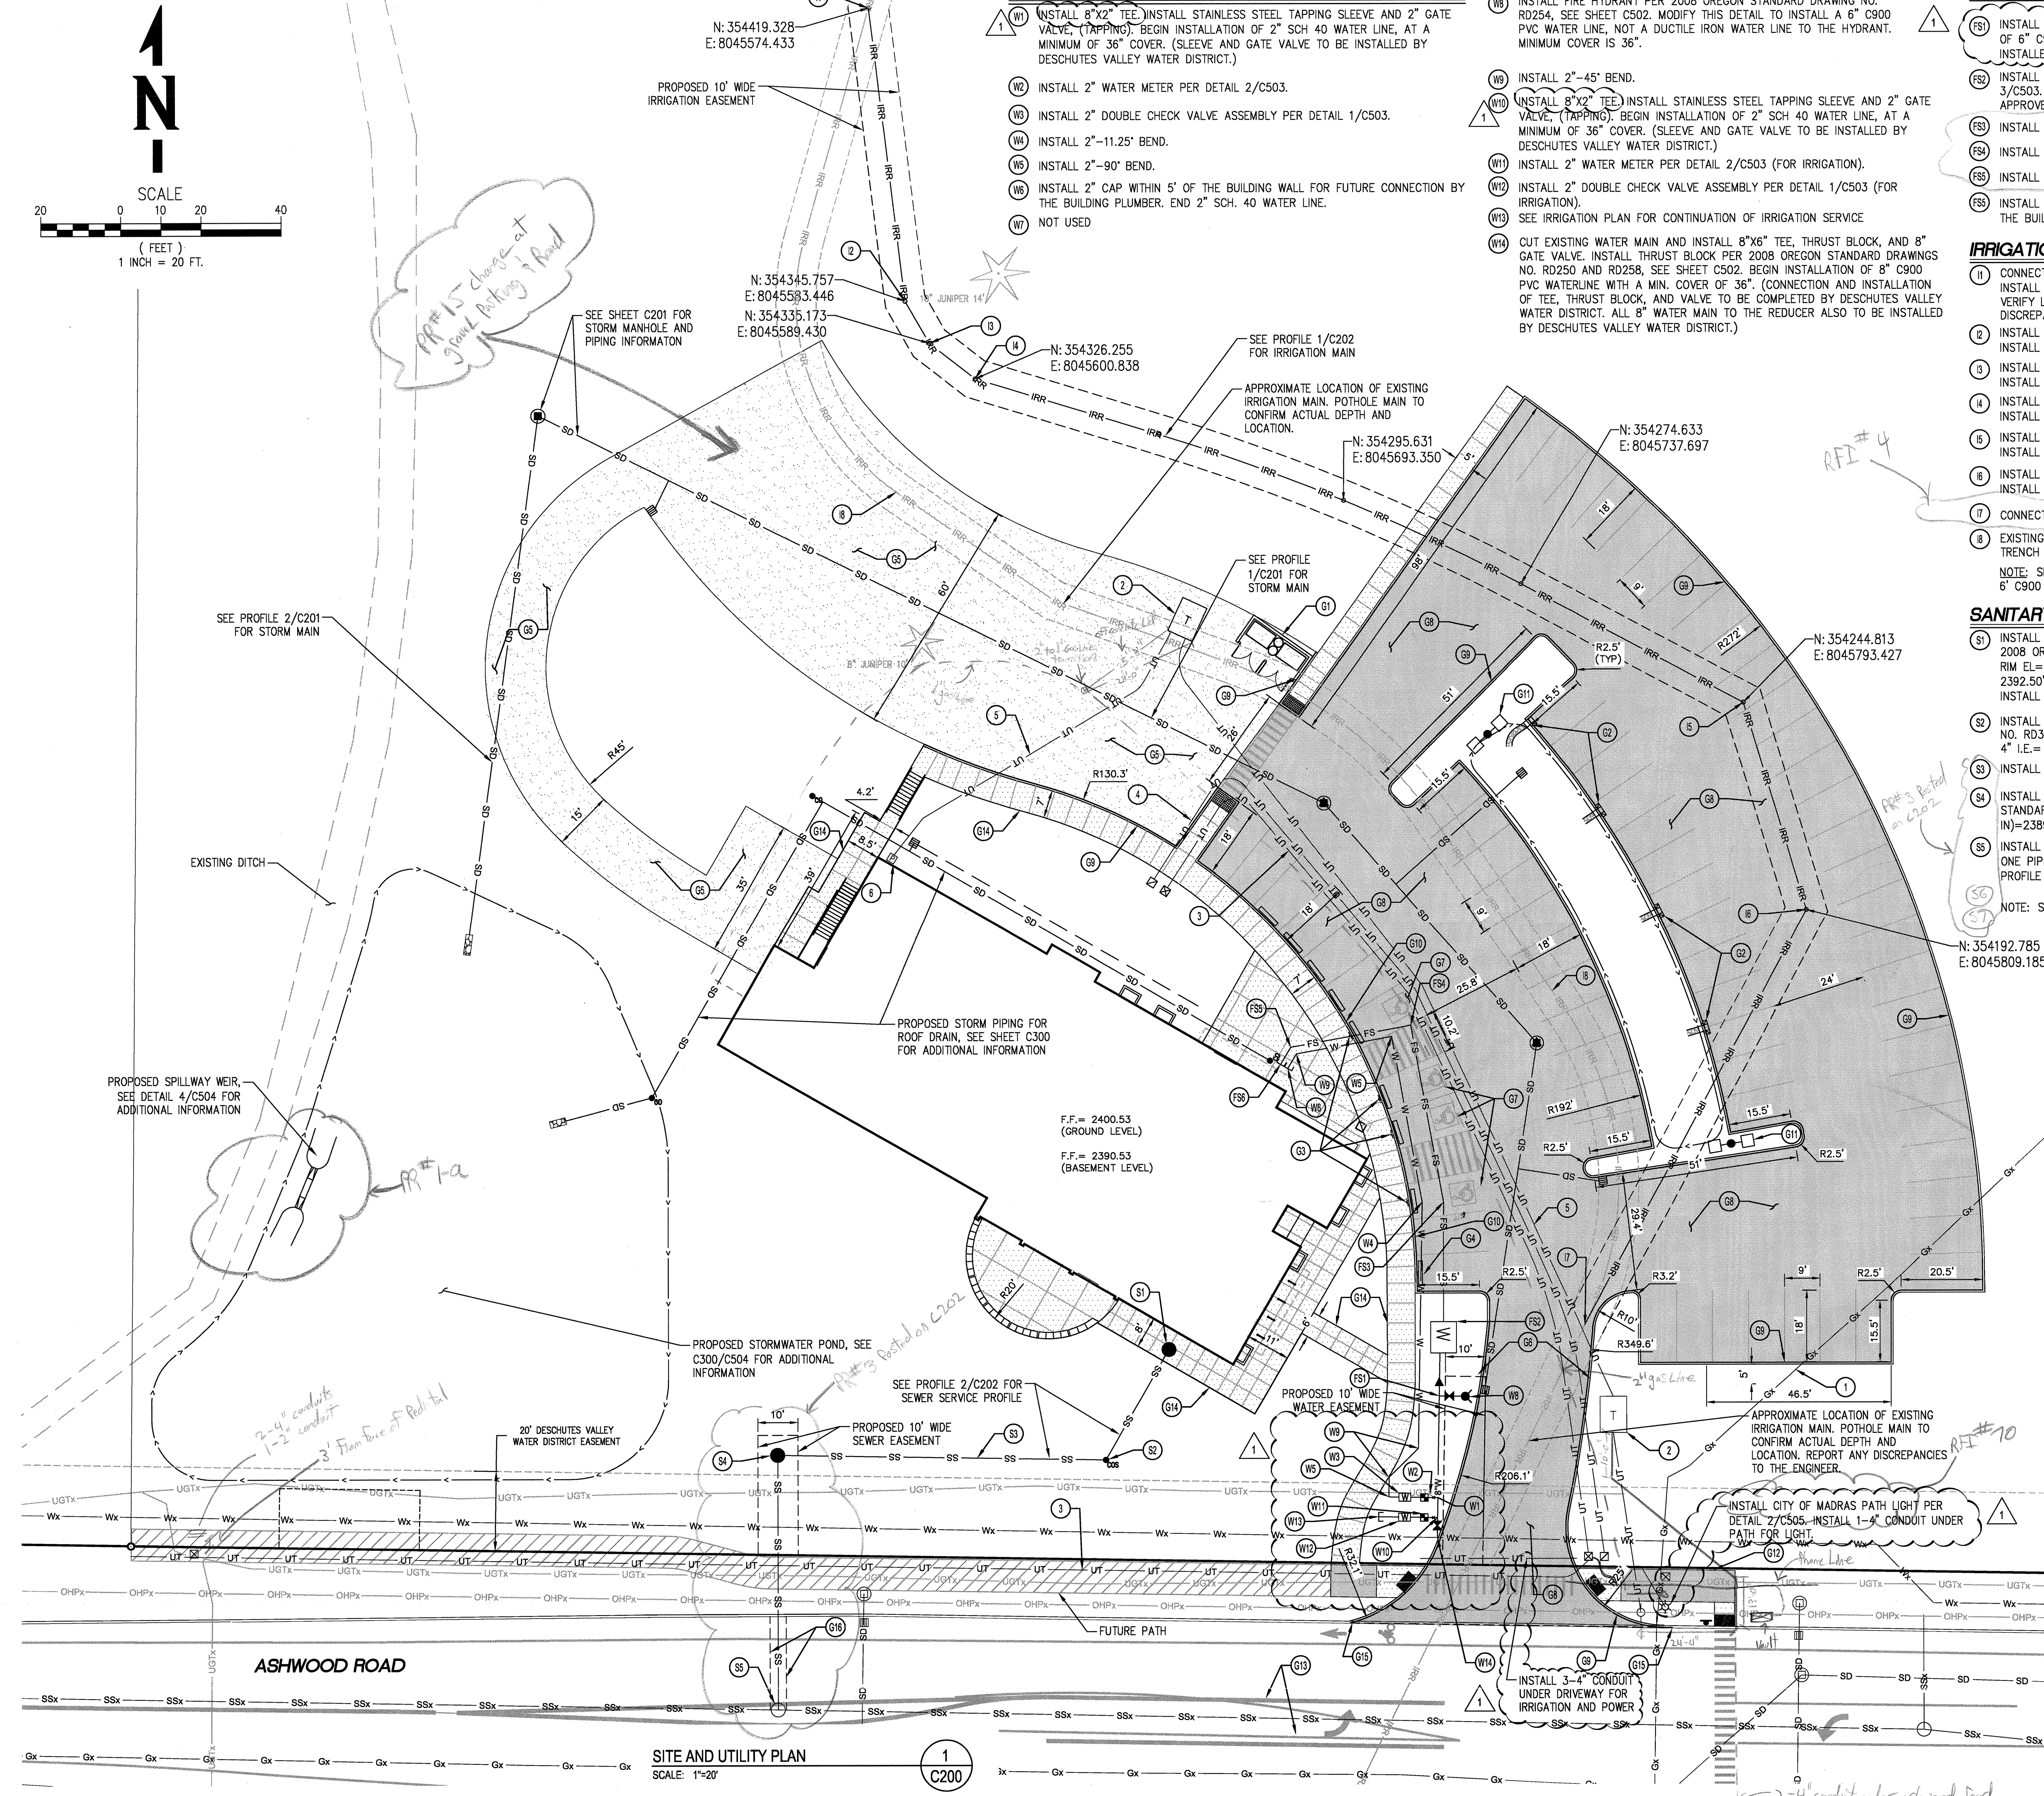

[DATE: 2/17/2011 10:40 AM] [AUTHOR: C:\pfd\Writer\p3] [STYLE: WHP-Standard.ctb] [PLOTTER: HP DesignJet 5000] [LAYOUT: C200 SITE AND UTILITY PLAN]

WHPacific
 103 SW Columbia Street
 Bend, OR 97702
 541-388-4255 Fax 541-388-4229
 www.whpacific.com

REGISTERED PROFESSIONAL ENGINEER
 52999PE
 OREGON
 FREDRICK A. HIRON
 EXPIRES: 06/30/2011

REVISIONS

NO.	BY	DATE	REMARKS
1	FAK	02/07/11	CITY OF MADRAS COMMENTS

SHEET INFO

DESIGNED	FAK/SCC	SCC/JMA	SCC/JMA	SCC/JMA	SCC/JMA	SCC/JMA	SCC/JMA
DRAWN	CHECKED	FAK	APPROVED	SRH	LAST EDIT	2/17/2011	SUBMITTAL

SCALE 1"=20'

SHEET NUMBER C200
 3 of 15

STEELE ASSOCIATES ARCHITECTS
 COCC MADRAS CAMPUS

STEEL ASSOCIATES ARCHITECTS LLC
 All rights reserved. Reproduction or use in any form or by any means - graphic, electronic, mechanical, etc. - without written permission of STEEL ASSOCIATES ARCHITECTS is prohibited and subject to criminal prosecution.

STEEL ASSOCIATES ARCHITECTS LLC
 760 NW YORK DRIVE, SUITE 200
 MADRAS, OREGON 97554
 541-382-9867 FAX 541-385-8816
 BEND, OR 97701
 info@steel-arch.com

COCC MADRAS CAMPUS EDUCATION CENTER
 ASHWOOD ROAD
 MADRAS, OREGON
 SITE AND UTILITY PLAN

REVISED	DATE	DATE
FINISHES MEETING	11/19/10	

JOB NO. 10110.01
 DATE 12/28/10
 DRAWN BY JI, DR, CS, ES, JW, STS
 REVISIONS DATE

C200
 3 OF 15 SHEETS

CONSTRUCTION SET - 02/11/11